




FIRST FLOOR PLAN
SCALE: 1/4" = 1'-0"

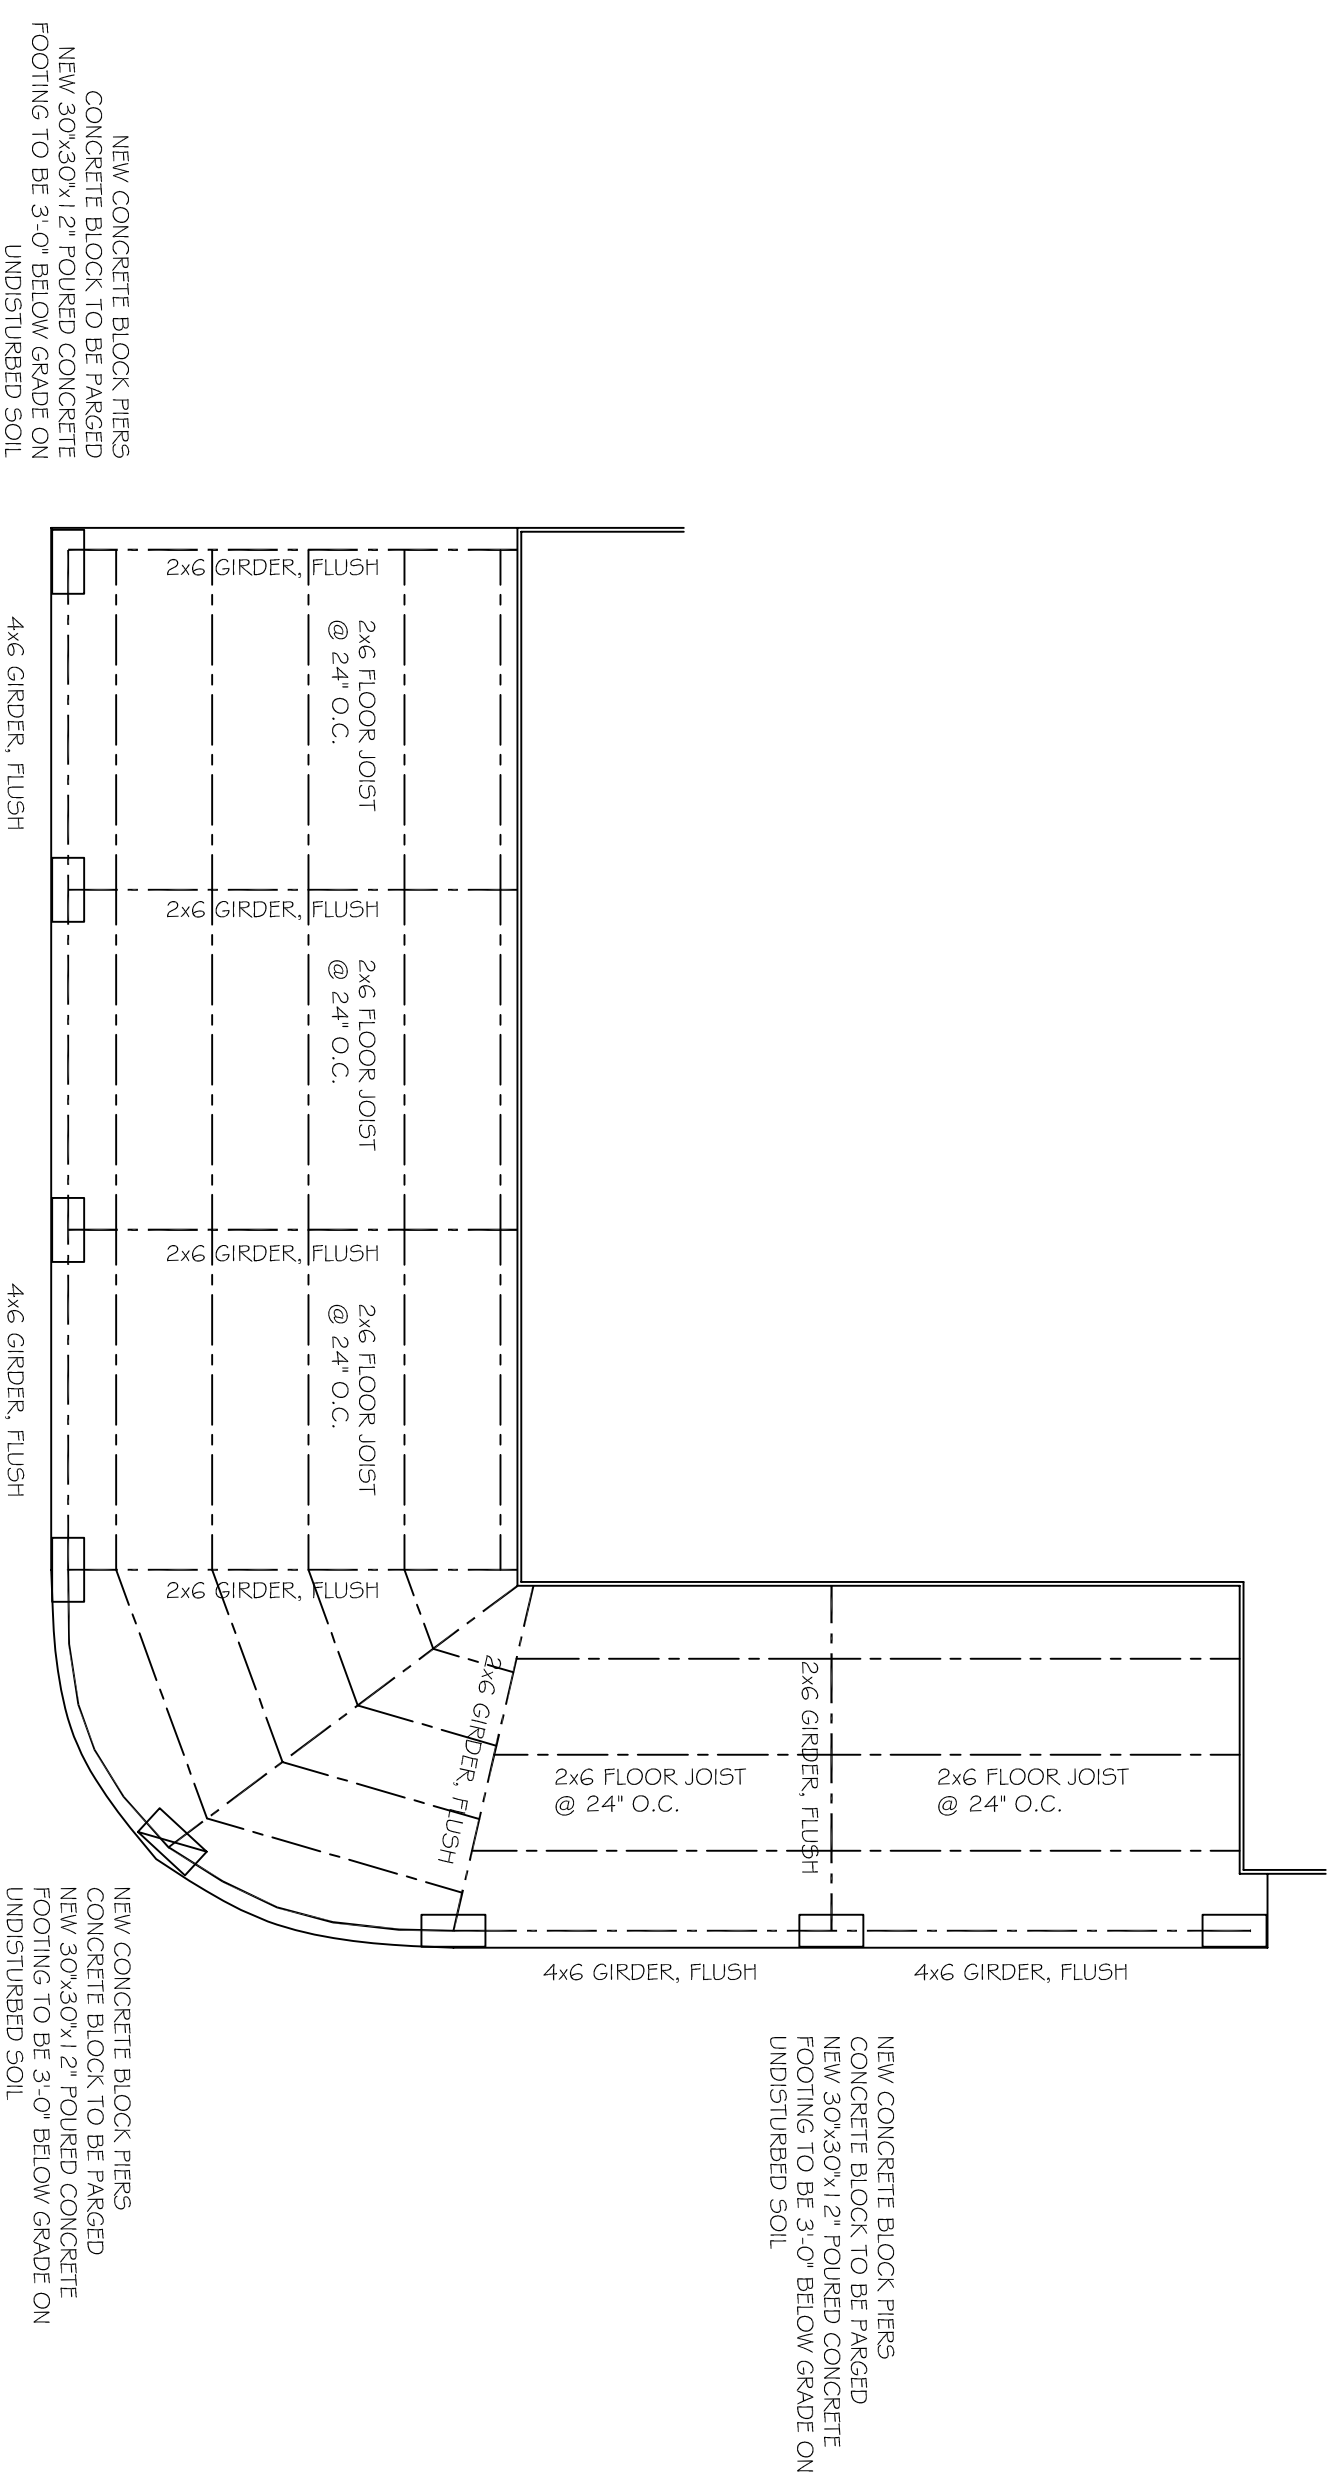


FOUNDATION PLAN
SCALE: 1/4" = 1'-0"
AS BUILT

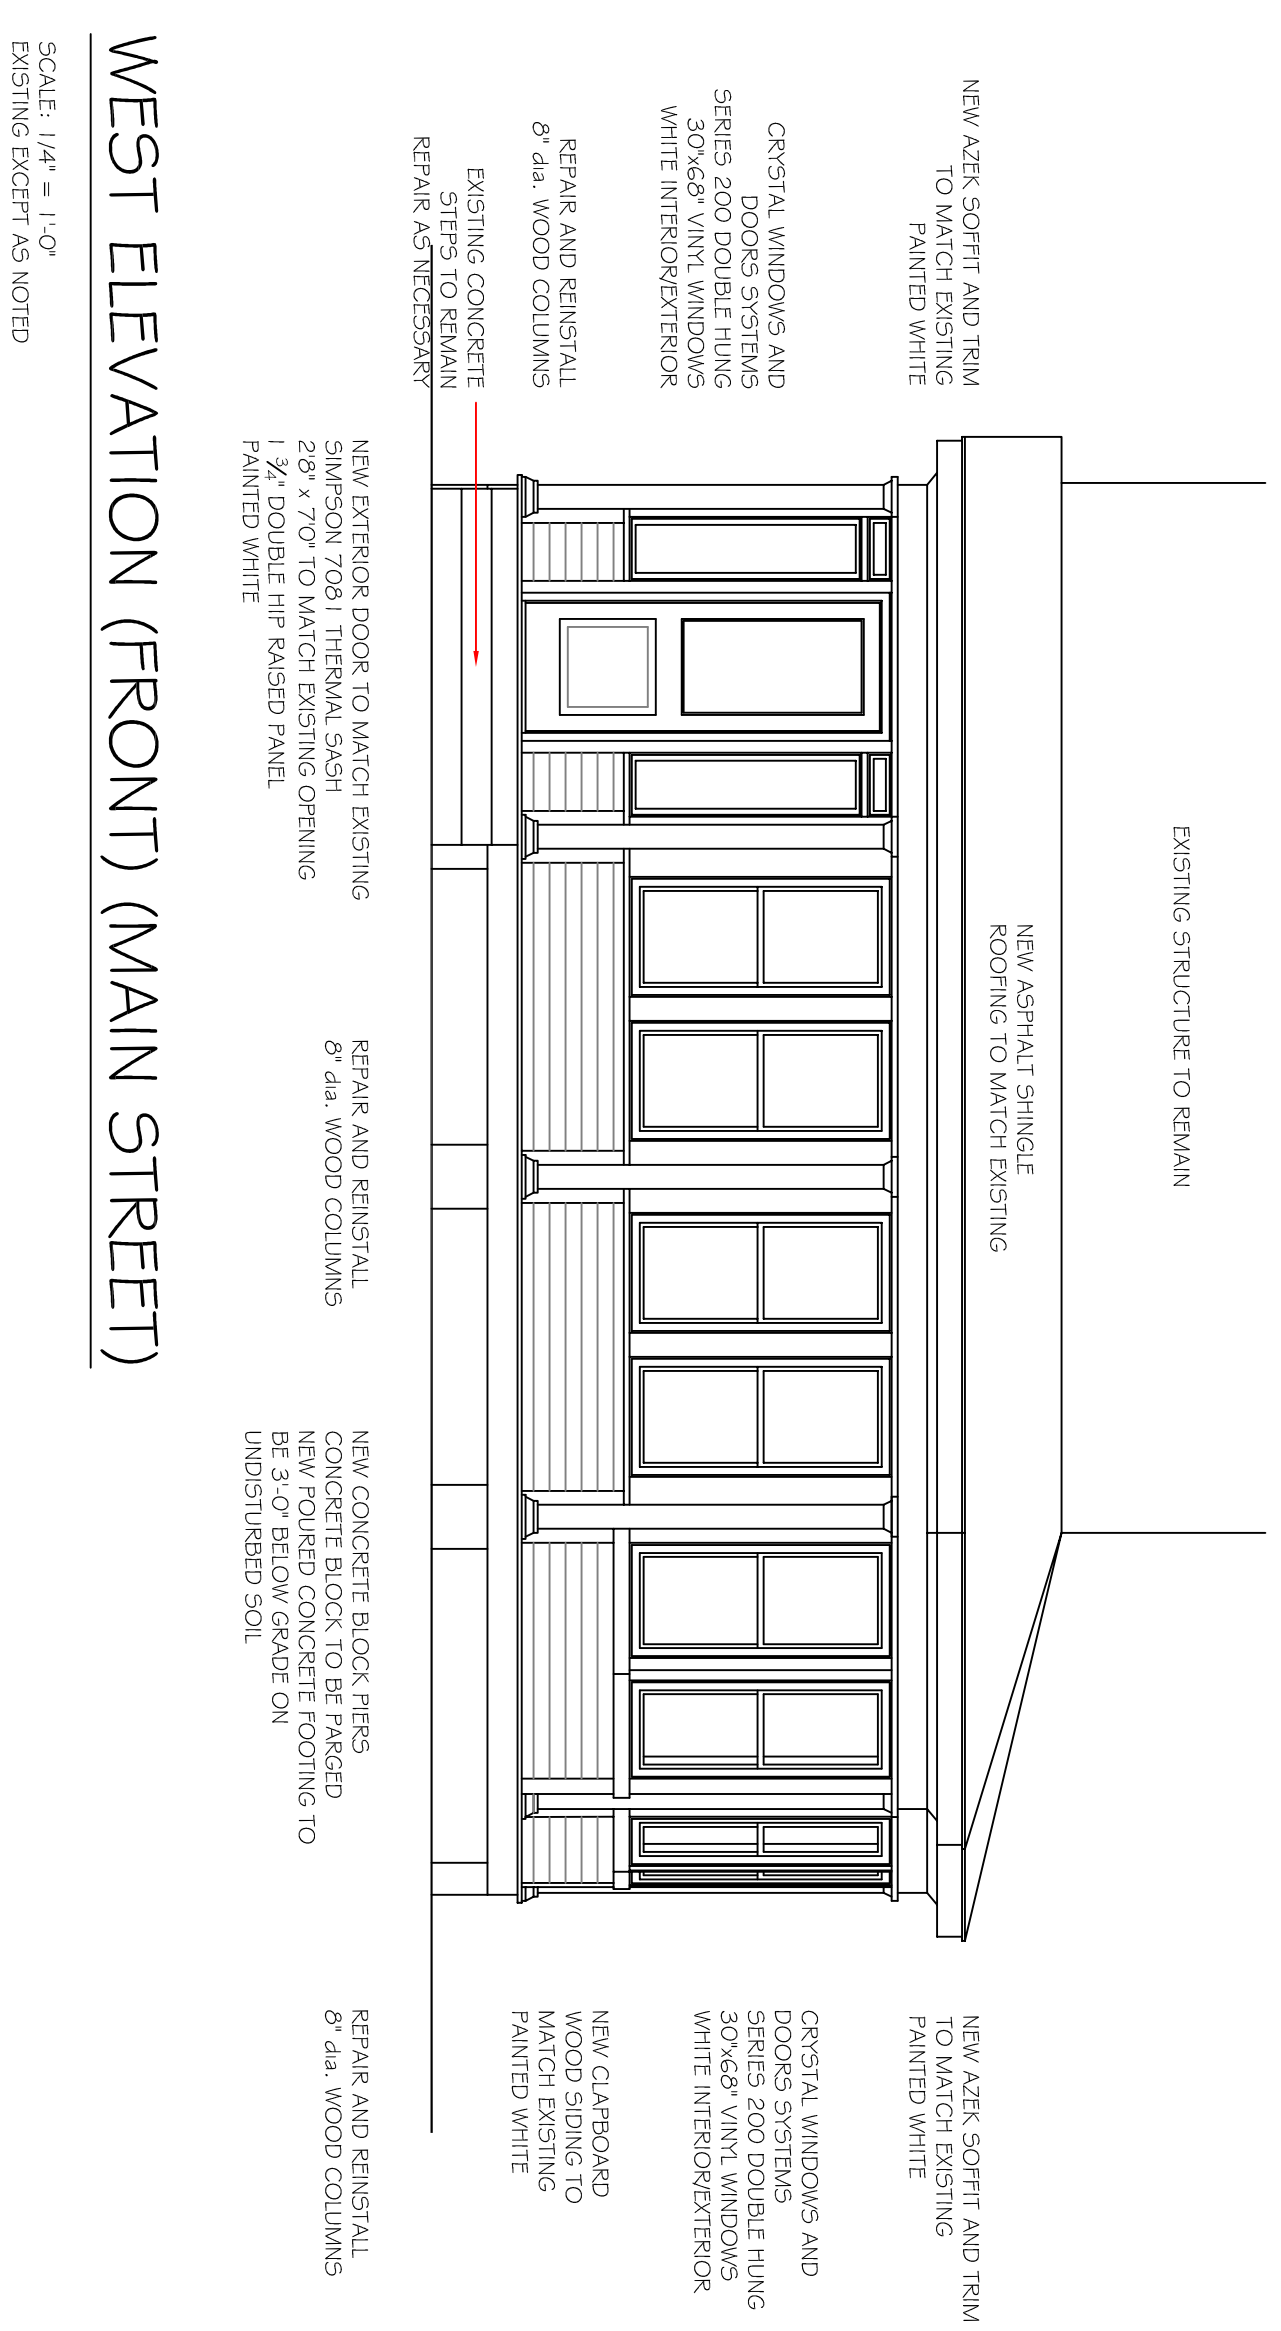

WEST ELEVATION (FRONT) (MAIN STREET)
SCALE: 1/4" = 1'-0"
EXISTING EXCEPT AS NOTED

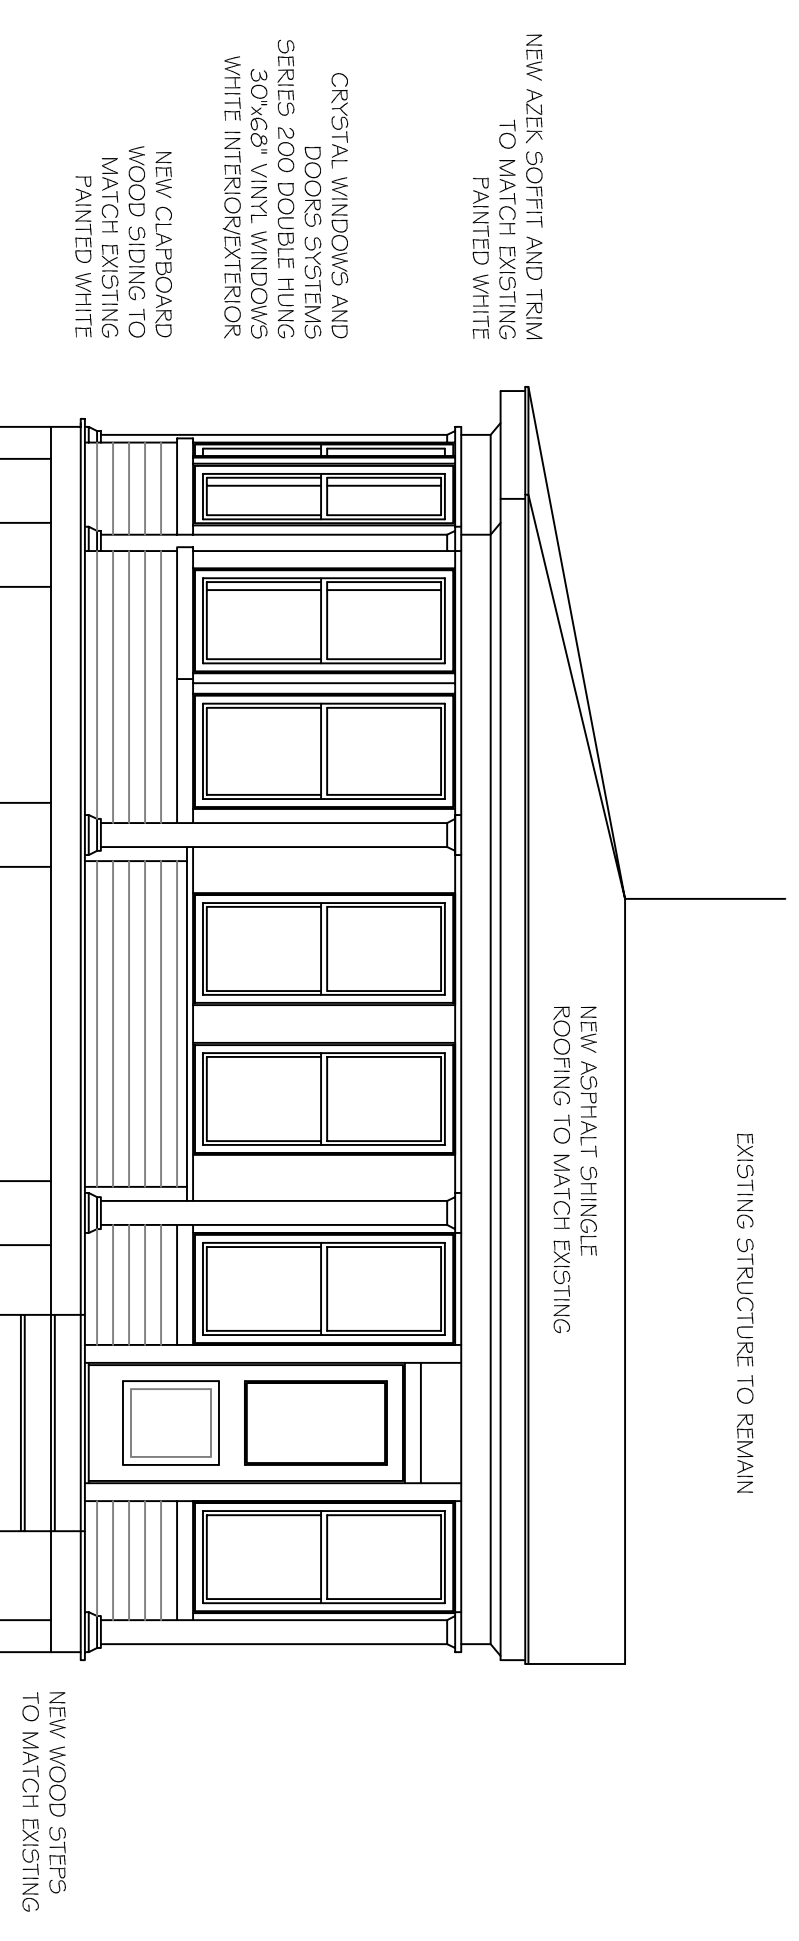

SOUTH ELEVATION (SIDE)
SCALE: 1/4" = 1'-0"
EXISTING EXCEPT AS NOTED

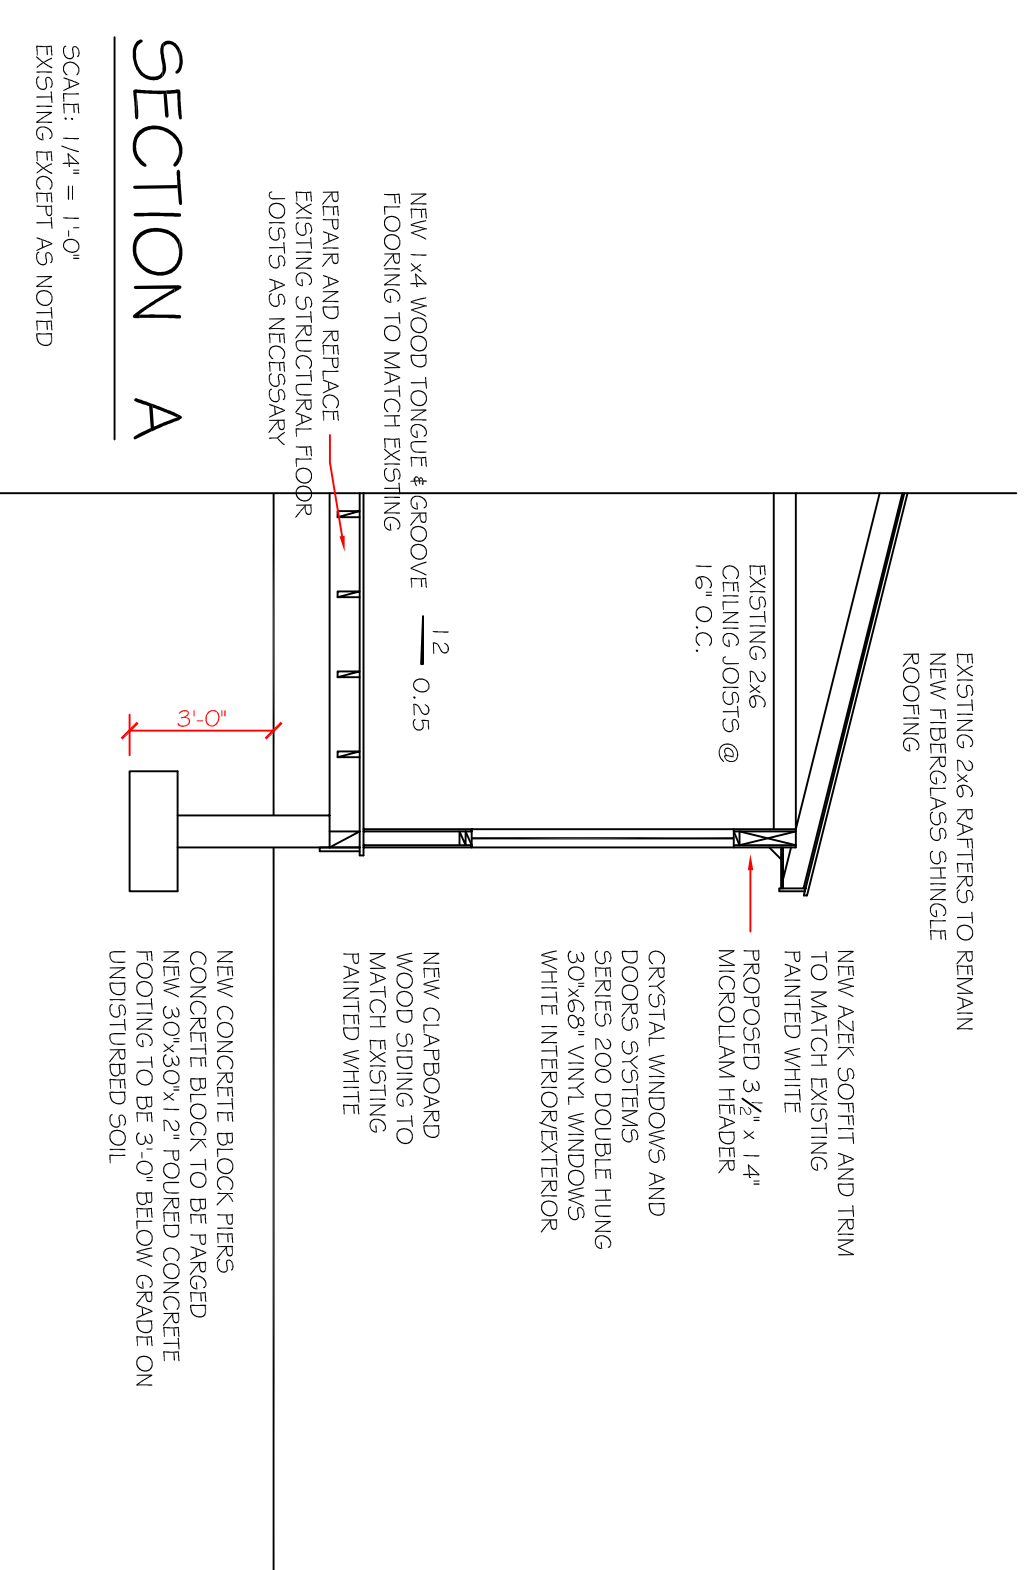

SECTION A
SCALE: 1/4" = 1'-0"
EXISTING EXCEPT AS NOTED

THESE PLANS ARE AN INSTRUMENT OF SERVICE AND ARE THE PROPERTY OF THE ARCHITECT. INFRINGEMENTS WILL BE PROSECUTED.
2020 ALL RIGHTS RESERVED

Robert I. Brown
Architect, P.C.

205 Bay Ave. Greenvort NY
info@rtibrownarchitect.com
531-477-9752

IT IS A VIOLATION OF THE LAW FOR ANY PERSON, OTHER THAN THE ARCHITECT, TO REPRODUCE OR ALTER THIS DRAWING IN ANY WAY. ANY AUTHORIZED ALTERATION MUST BE NOTED, SEALED, AND DESCRIBED IN ACCORDANCE WITH THE LAW.

CLIENT / OWNER

LAKEAS RESIDENCE

600 MAIN STREET
GREENPORT, NY 10944

PROJECT TITLE
**ENCLOSED PORCH
RENOVATION**

DRAWING TITLE
**FLOOR PLANS
ELEVATIONS**

04 AUGUST, 2020 SCALE: 1/4" = 1'-0"
DRAWING NO.

A1